ALT	DATE	DESCRIPTION	BY/APP	ALT.NO	ALT.DATE	ZONE	ALTERATIONS	AUTHORITY
M1	08.03.2019	IN DRG SPOT WELDING ADDED & CONTINUOUS WELDING MODIFIED TO SKIP WELDING. ECN NO. 84900051.	RKC / SMR	NIL	NIL	NIL	NIL	NIL

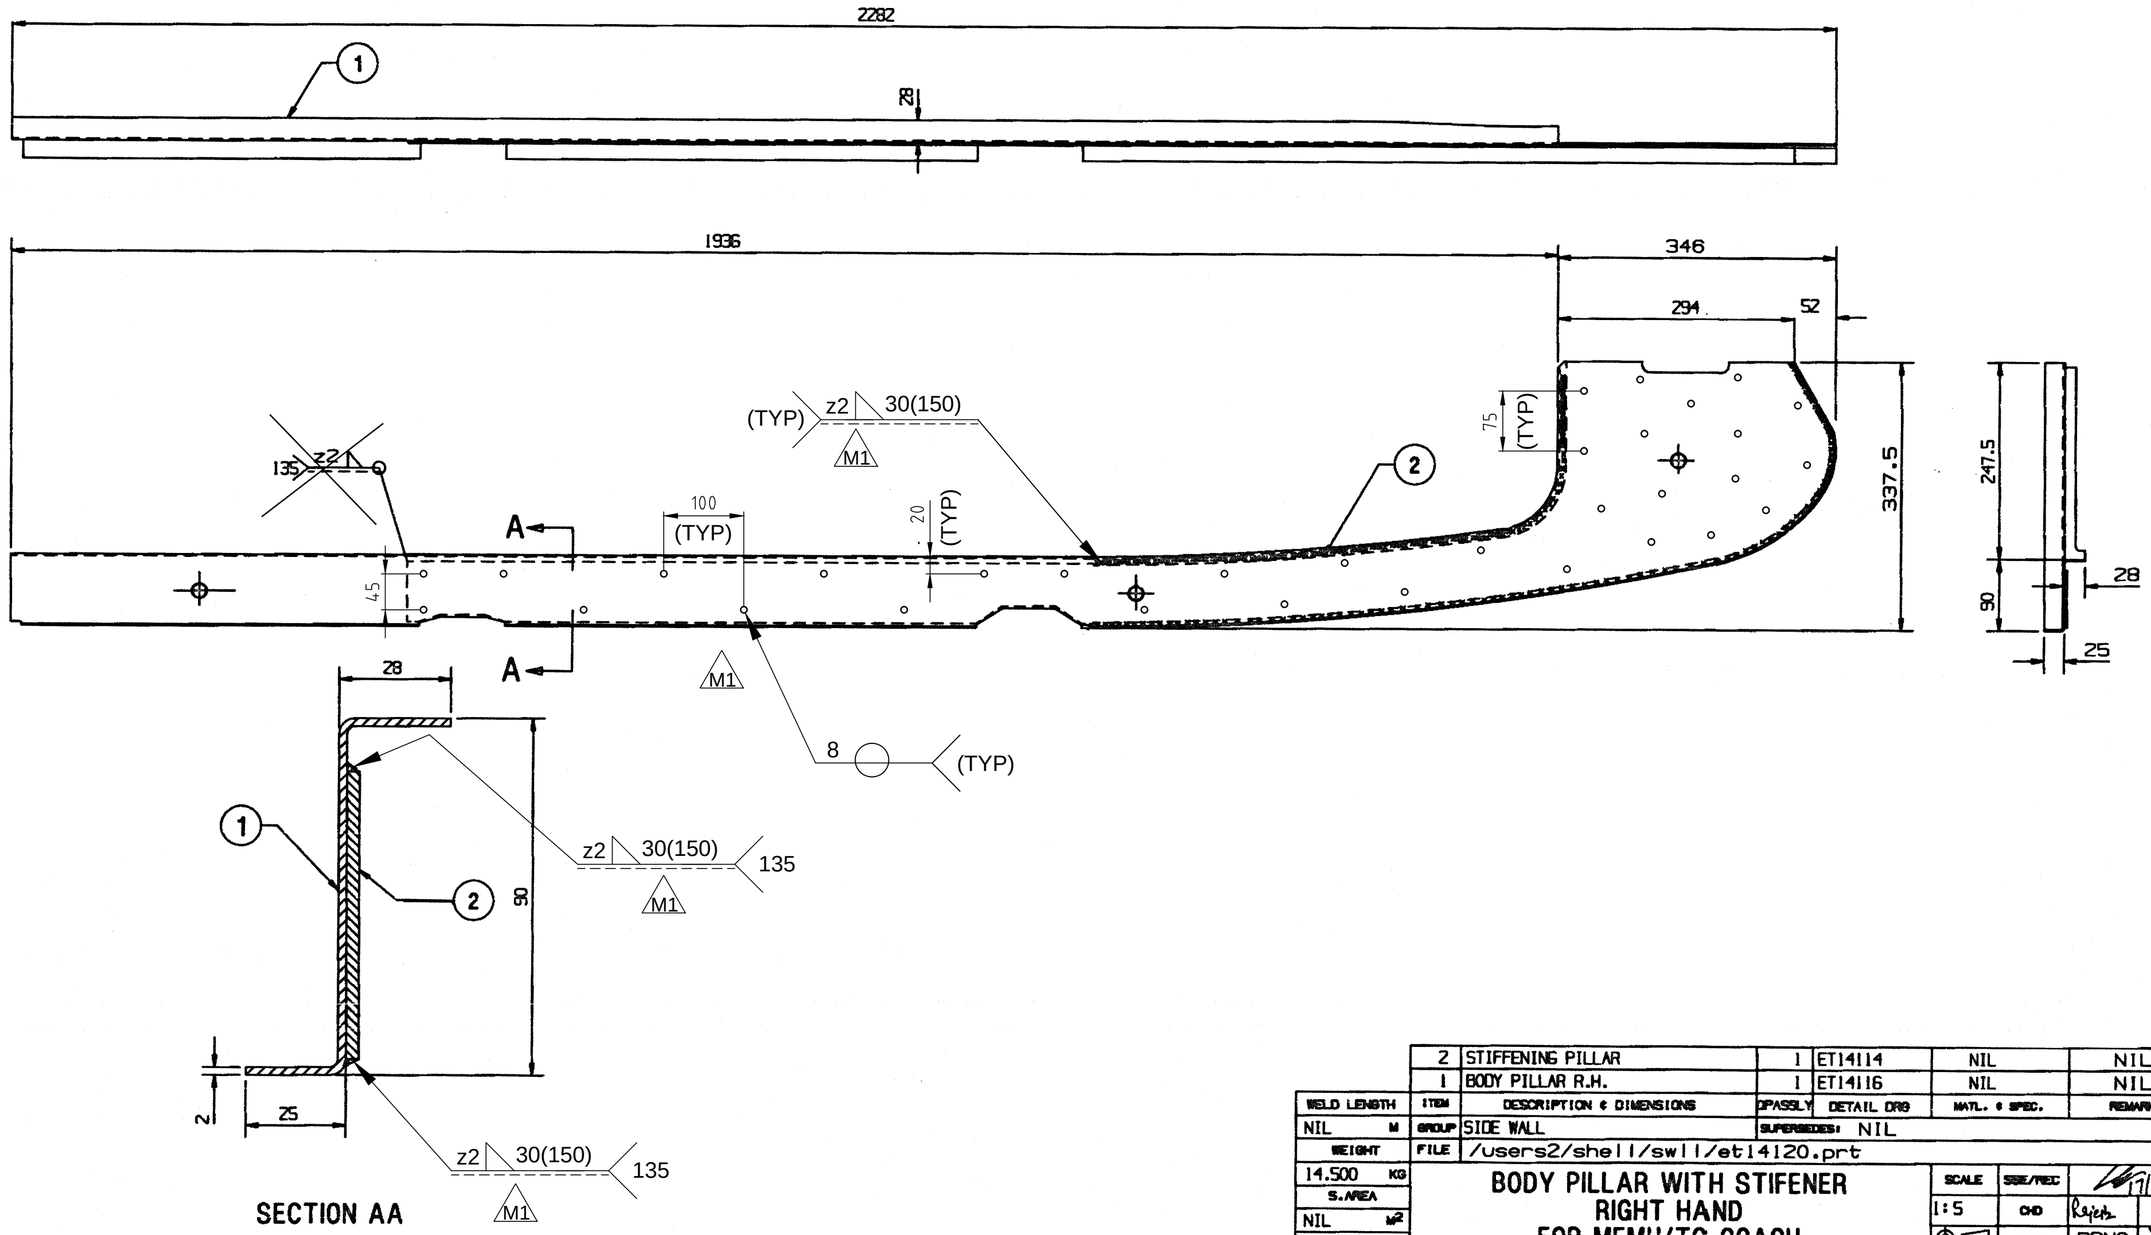

2	STIFFENING PILLAR	1	ET14114	NIL	NIL
1	BODY PILLAR R.H.	1	ET14116	NIL	NIL

WELD LENGTH	ITEM	DESCRIPTION & DIMENSIONS	QPASSLY	DETAIL DRG	MATL. & SPEC.	REMARKS
NIL M	GROUP	SIDE WALL	SUPERSEDES: NIL			
WEIGHT	FILE	/users2/shell/swll/et14120.prt				
14.500 KG		BODY PILLAR WITH STIFENER RIGHT HAND FOR MEMU/TC COACH	SCALE	SSE/REC	17/11/99
S.AREA			1:5	CHD	Rajesh
NIL M²				DRN	PRNC LOBIN
LENGTH / ~~DIA~~		RAIL COACH FACTORY, KAPURTHALA	REF.DRG.No.	MEMU/TC2-1-4-207 COL-V	
2.282 M		INDIAN RAILWAYS STANDARD	PL NO.	05046531	
~~WIDTH / THICK~~					
NIL M			DRG. NO.	ET14120 M1	
HEIGHT					
NIL M		ADE/SME DY.CME CDE	ALT. NIL	SHEET 1/1	

THIS IS A COMPUTER GENERATED DRAWING. ANY MANUAL ALTERATION SHALL AUTOMATICALLY RENDER IT INVALID.

FOR UNTOLERANCED DIMENSIONS REFER MDG0008 | ~~REVIEW NO.__ /PROTOTYPE~~/FINAL | DATE OF FIRST ISSUE 14/10/99